
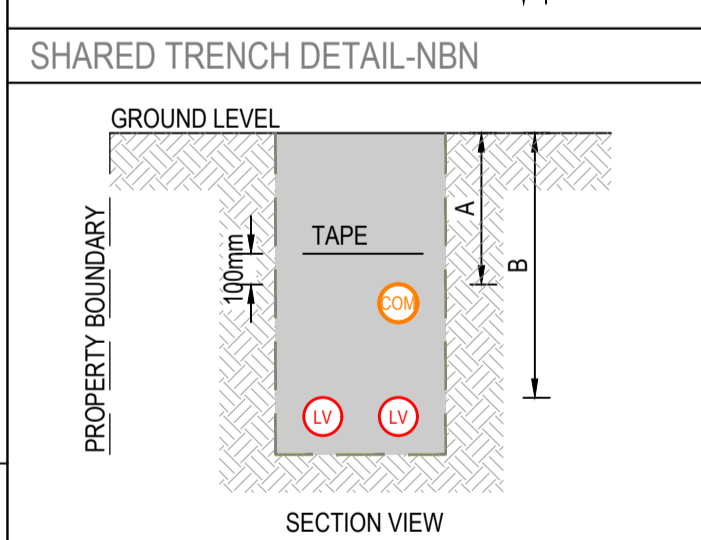


**LEGEND: NBN CONDUITS & PITS**

- Fibre Access Node (FAN) site
- FDH-ID Fibre Distribution Hub (FDH) site - 1m x 1m
- P100 4.0 Proposed 100mm Main Conduit
- P50 2.5 Proposed 50mm Lateral Conduit
- P20 7 Proposed 20mm Service Drop
- Proposed length of bored conduit
- Proposed shared trench
- Service Drop Access Pit
- Local Network Pit
- Premises Connection (Houses an MPT)
- Boundary Pit
- Cross-Road & Other Premises Connection (No MPT)
- Local Network Connection Pit
- Premises Connection & Fibre Splice Closure
- Distribution / Local Network Connection Pit
- at entry/exit to estate; @ 250m ccs on distribution conduit
- Fibre Distribution Hub (FDH) Pit
- Within 5m of FDH Site
- Multi Dwelling Unit (MDU)
- Transformer Pad Mount / Pole Mount
- Existing Telstra conduit trench layout (Proposed conduit indicated for comms cable)
- Existing NBN 100mm conduit
- Existing Telstra P100 conduit
- Existing or proposed Energex pole (& pole ID)
- ID-001
- Existing Telstra Exchange
- Existing Telstra Pits (size 2,3,4,5,6,7,8 or 9)
- Existing Telstra Manholes (Access Chambers)
- Existing Traffic Signals Box
- Existing network item to be removed/replaced
- 'C' communications marker plate

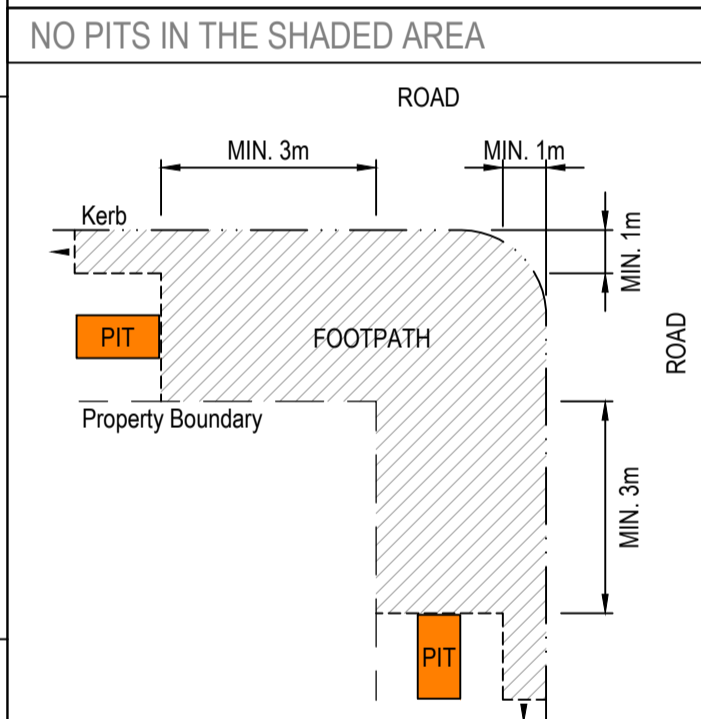


**MINIMUM CONDUIT DEPTH \***

LOCATION	A	B
Verge	450mm	750mm
Local Road	600mm	Energex 800mm; Ergon 900mm
DTMR Road	800mm	1200mm

\* supercedes Energex/Ergon requirements

**AS CONSTRUCTED**

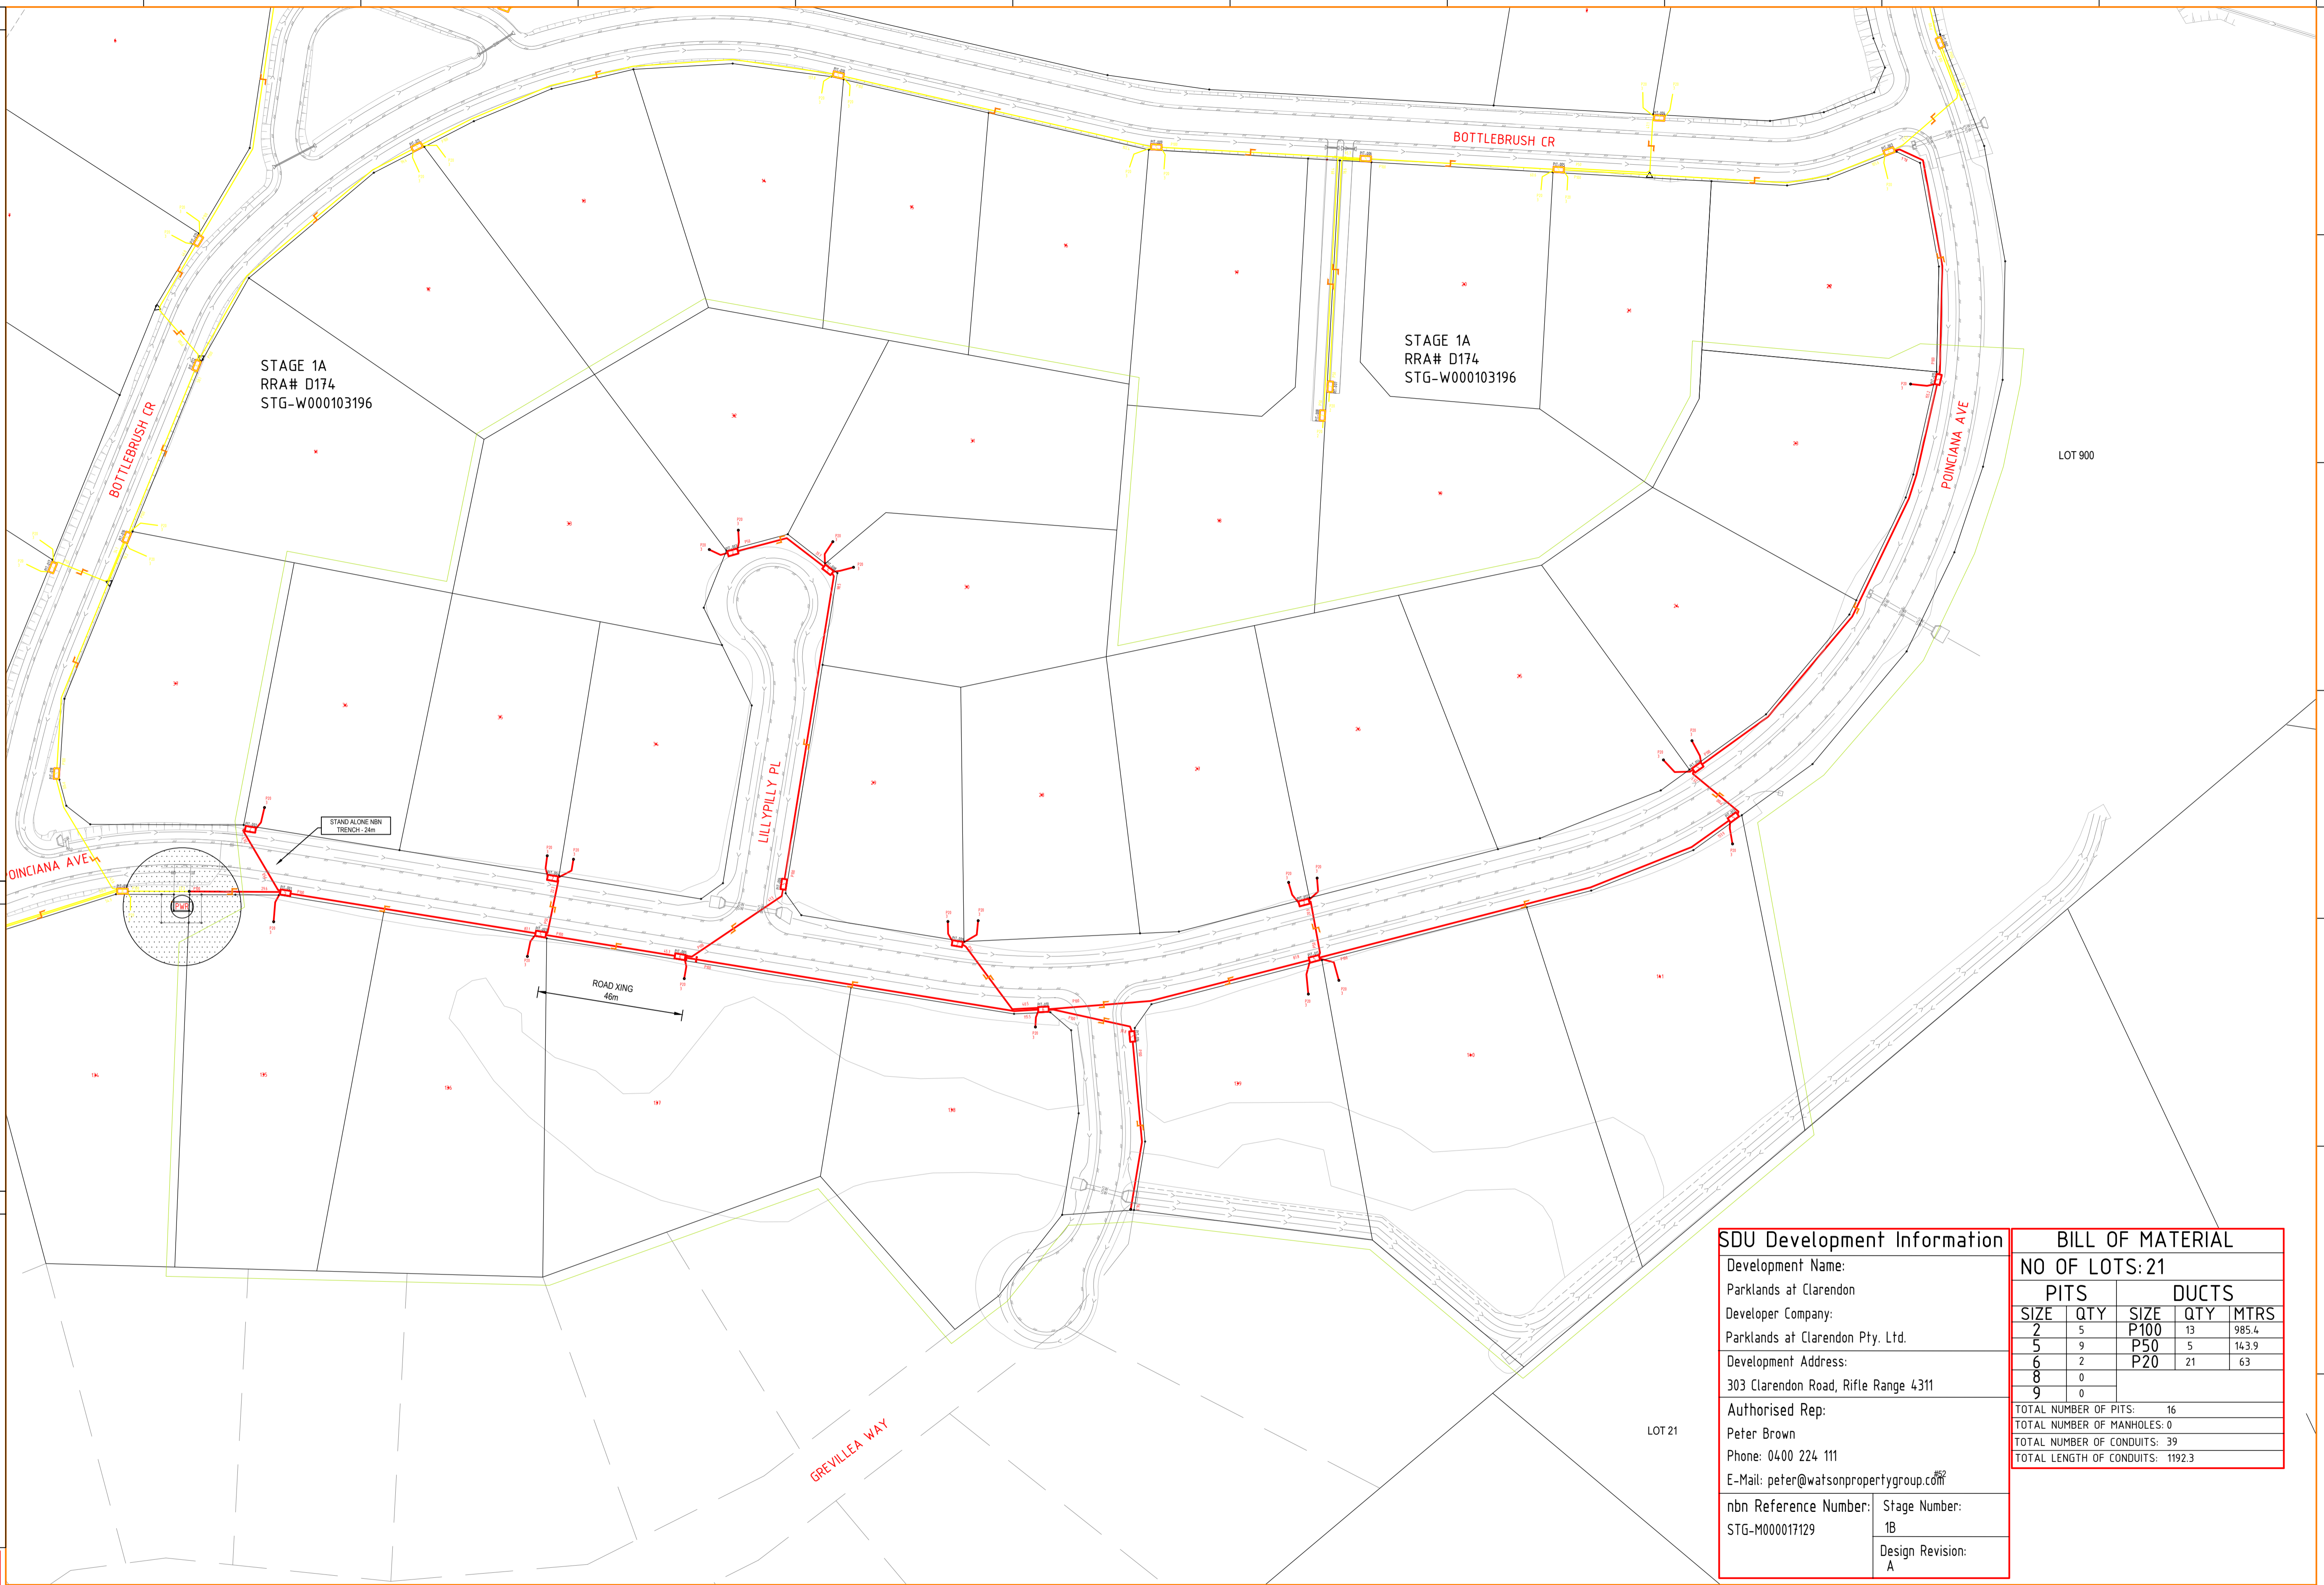

**SDU Development Information**

Development Name:  
Parklands at Clarendon

Developer Company:  
Parklands at Clarendon Pty. Ltd.

Development Address:  
303 Clarendon Road, Rifle Range 4311

Authorised Rep:  
Peter Brown  
Phone: 0400 224 111  
E-Mail: peter@watsonpropertygroup.com

nbn Reference Number: STG-M000017129

Stage Number:  
1B  
Design Revision:  
A

**BILL OF MATERIAL**

NO OF LOTS: 21

PITS		DUCTS	
SIZE	QTY	SIZE	MTRS
2	5	P100	985.4
5	9	P50	143.9
6	2	P20	63
8	0		
9	0		

TOTAL NUMBER OF PITS: 16  
TOTAL NUMBER OF MANHOLES: 0  
TOTAL NUMBER OF CONDUITS: 39  
TOTAL LENGTH OF CONDUITS: 1192.3



**STRICTLY CONFIDENTIAL**

NBNC APPROVAL RECORD:

REV	DATE	DRAFTER	DESCRIPTION	APPROVED
B	11/02/2021	S.M.	AS BUILT	K.R.
A	01/10/2020	SHANE MILLS	ORIGINAL	K.R.

**STRICTLY CONFIDENTIAL**

NBNCO QUALITY RECORD:

SIGNATURE: \_\_\_\_\_ DATE: \_\_\_\_\_

DD \_\_\_\_\_  
WD \_\_\_\_\_  
AB \_\_\_\_\_

QUALITY RECORD:

NBNCO DISCLAIMER  
THIS DOCUMENT HAS BEEN PREPARED SOLELY FOR THE USE OF NBNCO LIMITED (ABN 86 136 533 741) FOR USE IN MAINTAINING NBNCO FACILITIES. IT HAS NOT BEEN CREATED FOR ANY OTHER USE. IT SHOULD NOT BE SCALED TO LOCATE NBNCO ASSETS. NO WARRANTY IS GIVEN THAT THE INFORMATION IS ACCURATE OR COMPLETE.

**Australia's broadband network**

**Robinson Russell**  
& ASSOCIATES PTY. LTD.  
CONSULTING ENGINEERS - ELECTRICAL

204/6 Barbara Street  
Stairford, QLD 4053  
Tel: (07) 3872 5555  
Fax: (07) 3872 5566  
E: r@robins.com.au  
www.robins.com.au

A.B.N. 78 010 588 661

**KEY PLAN**

DRAWING TITLE:  
Parklands at Clarendon Stage 1B  
Clarendon Road  
Rifle Range  
4311

ENABLE#: 279321

STATE: QLD REGION:

FSA: SAM: ADA:

PROJECT No: STG-M000017129

CADREF No: D175

SCALE 1:1000 SHEET No. 1 OF 1 REV. B

REV	DATE	DRAFTER	DESCRIPTION	APPROVED
B	11/02/2021	S.M.	AS BUILT	K.R.
A	01/10/2020	SHANE MILLS	ORIGINAL	K.R.